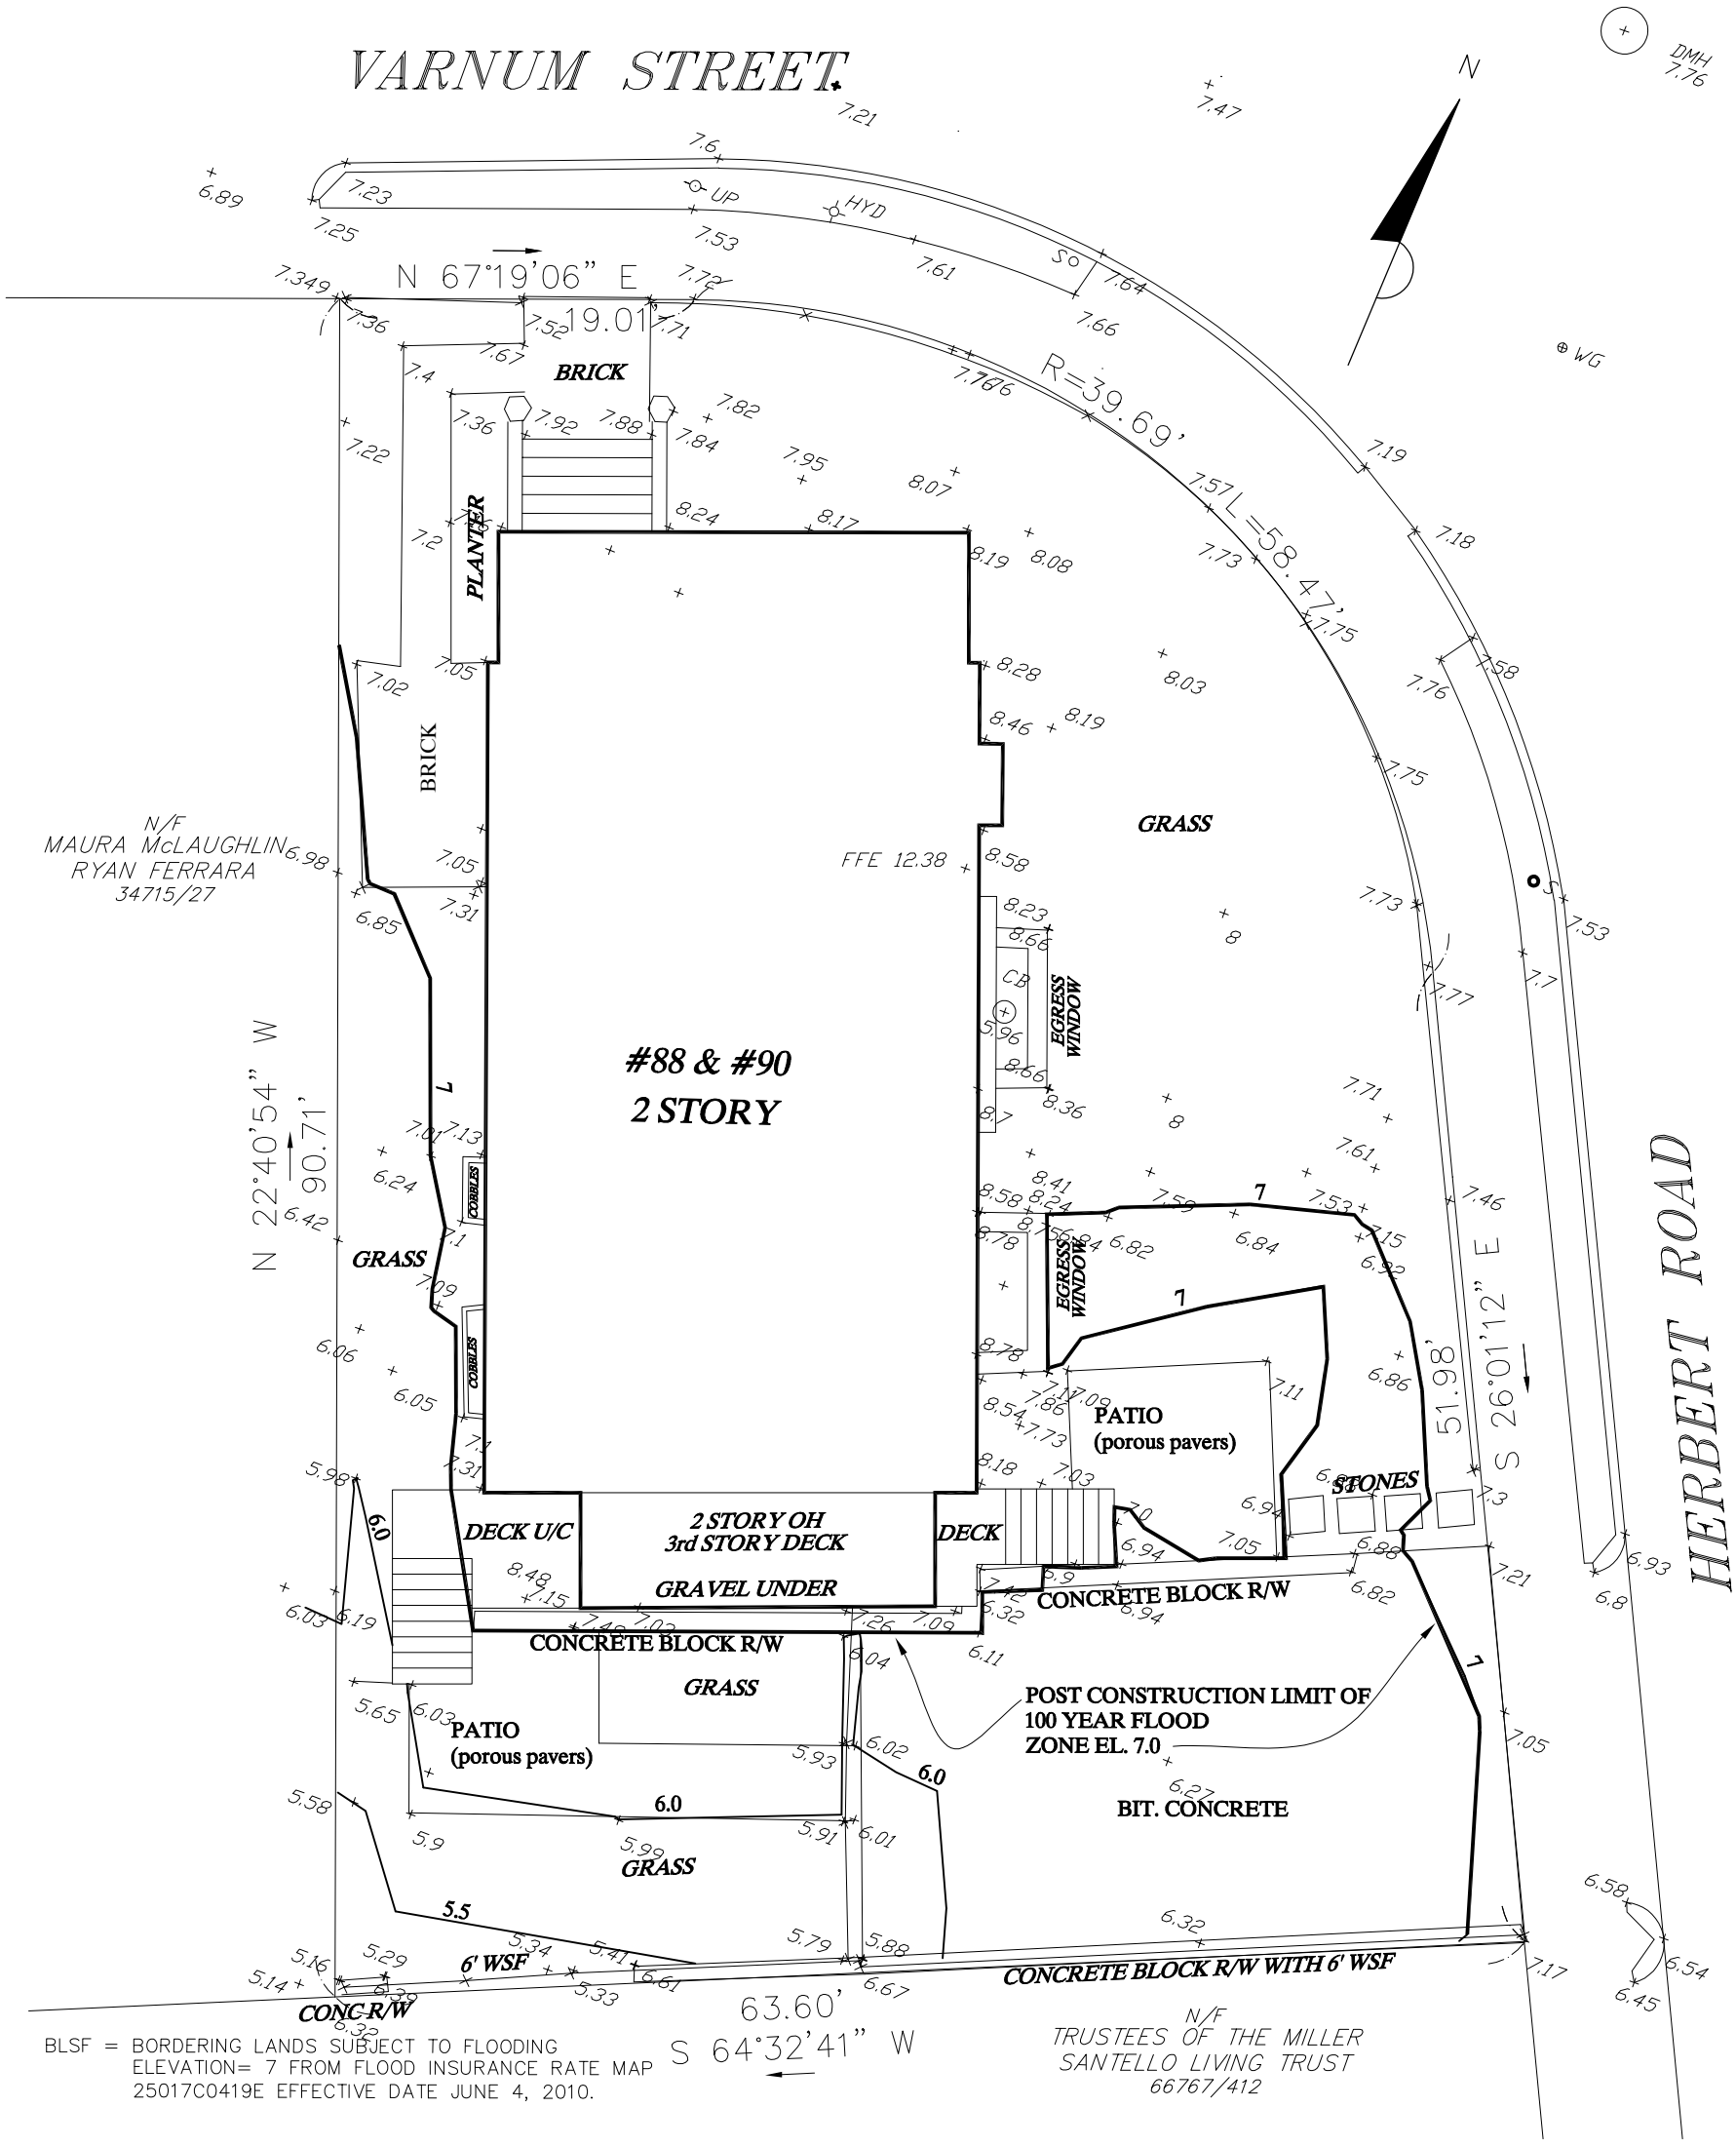


BLSF = BORDERING LANDS SUBJECT TO FLOODING
ELEVATION= 7 FROM FLOOD INSURANCE RATE MAP
25017C0419E EFFECTIVE DATE JUNE 4, 2010.

## SITE PLAN

SCALE: 1" = 10'

Flood Plain As-Built Plan
88-90 Varnum Street - Arlington, MA

Gala Simon Associates
GSA
394 Lowell Street
Suite 18
Lexington, MA 02420
Civil Engineers 781-676-2962

COMMONWEALTH OF MASSACHUSETTS
ALBERTO M. GALA
CIVIL
No. 36434
REGISTERED PROFESSIONAL ENGINEER

# AB-1

January 23, 2020

Project #1904